

LEGEND OF SYMBOLS & ABBREVIATIONS

| | | |
|--------------------|----------------------------|--------------------------------|
| ○ UTILITY POLE | ⊙ MANHOLE | P.O.C. POINT OF COMMENCEMENT |
| ⊛ LIGHT POLE | ⊙ SANITARY MANHOLE | P.O.B. POINT OF BEGINNING |
| ⊞ TRANSFORMER | ● STORM STRUCTURE (CLOSED) | ° DEGREES |
| ⊞ UTILITY PEDESTAL | ⊞ STORM STRUCTURE (OPEN) | ' FEET/MINUTES |
| ⊞ TRAFFIC SIGNAL | ⊞ CURB INLET | " INCHES/SECONDS |
| ⊞ SIGNAL BOX | ⊙ VALVE VAULT | S.F. SQUARE FEET |
| ⊞ GAS VALVE | ⊞ FLARED END SECTION | (R) RECORD BEARING/DISTANCE |
| ⊞ WATER VALVE | —W— WATER LINE | TF TOP OF FOUNDATION |
| ⊞ ELECTRIC METER | —T— TELEPHONE/CATV LINE | FF FINISHED FLOOR |
| ▲ GAS METER | —G— GAS LINE | TP TOP OF PIPE |
| ⊞ FIRE HYDRANT | —E— ELECTRIC LINE | B.S.L. BUILDING SETBACK LINE |
| ⊞ AUTO SPRINKLER | —OH— OVERHEAD WIRES | P.U.E. PUBLIC UTILITY EASEMENT |
| ⊞ MONITORING WELL | —ST— STORM SEWER | D.E. DRAINAGE EASEMENT |
| ⊞ GROUND LIGHT | —SAN— SANITARY SEWER | L ARC LENGTH |
| ● BOLLARD | —X— CHAIN LINK FENCE | R RADIUS LENGTH |
| ● B/BOX | —□— STOCKADE FENCE | C CHORD LENGTH |
| ▲ SIGN | —G— GUARD RAIL | CB CHORD BEARING |
| ~ FLAG POLE | ⊞ CONCRETE SURFACE | CMP CORRUGATED METAL PIPE |

AREA: CANTERA CROSSING
 LOT 1: 415,515.32 SF± OR 9.538 ACRES±
 LOT 2: 317,084.62 SF± OR 7.279 ACRES±
 TOTAL: 732,599.94 SF± OR 16.818 ACRES±

AREA: LIBERTY MUTUAL AT CANTERA
 LOT 1: 538,137.49 SF± OR 12.353 ACRES±
 LOT 2: 194,462.45 SF± OR 4.464 ACRES±
 TOTAL: 732,599.94 SF± OR 16.818 ACRES±

VICINITY MAP - NOT TO SCALE



ITEMS CORRESPONDING TO SCHEDULE B-II

- ⑥ Perpetual Easement Grant recorded February 26, 1957 as document 833687 in favor of the Illinois State Toll Highway Commission for highway purposes, including but not limited to construction, relocation, operation, regulation and maintenance of an access or bypass road over said premises, and Parking Setback as shown on plat of Cantera SubArea F Resubdivision recorded April 23, 2002 as document R2002-110194. Item is platted hereon.
- ⑩ Terms and provisions contained in Ordinance No. 1491 approving Plat of Easement Grant for public utility purposes recorded February 20, 1997 as document R97-024839, together with 20' and 30' public utility easements along the East line as shown on Sheet 13 of 13 attached thereto. Item is platted hereon.
- ⑫ Terms and provisions contained in the Declaration of Protective Covenants, Conditions, Restrictions and Easements, relating in part to association assessments and lien therefore, recorded December 18, 1998 as document R98-268977. Partial Release of Declaration of Protective Covenants, Conditions, Restrictions and Easements recorded April 23, 2002 as document R2002-110196. Addition of Property to Declaration of Protective Covenants, Conditions, Restrictions and Easements recorded April 23, 2002 as document R2002-110197. Partial Assignment of Deed Provisions recorded June 2, 2008 as document R2008089260 made by Warrenville Development Limited Partnership, an Illinois limited partnership to Cantera Owners Association, an Illinois notforprofit corporation. Partial Assignment of Deed Provisions recorded June 18, 2008 as document R2008-098321 and rerecorded June 23, 2008 as document R2008-100721, made by Warrenville Development Limited Partnership, an Illinois limited partnership to Cantera Owners Association, an Illinois notforprofit corporation. Item is blanket in nature.
- ⑬ Building setback line as shown on the Plat of Cantera SubArea F recorded August 5, 1999 as document R1999-171251, as follows:
Affects the Easterly 150 feet, the Southerly 80 feet and the Westerly 20 feet, as shown on the survey . Item is platted hereon.
- ⑭ Parking setback line as shown on the Plat of Cantera SubArea F recorded August 5, 1999 as document R1999-171251, as follows:
135 feet from the centerline of Mill Street, as shown on the survey. Item is platted hereon.
- ⑯ Terms and provisions contained in Declaration of Restrictive Covenant recorded April 23, 2002 as document R2002-110199, restricting the use of the land. Item is not survey related.

ITEMS CORRESPONDING TO SCHEDULE B-II

- ⑳ Cross Access Easement and Corner Sight Easement as shown on the Plat of Cantera Corporate Center recorded June 13, 2005 as document R2005-122468 along the Westerly line of Lot 2. Item is platted hereon.
- ㉑ Terms, provisions and conditions contained in Access Easement Agreement recorded June 13, 2005 as document R2005-122469, relating to access to and from Bella Vista Parkway, together with the rights of the adjoining owners in and to the concurrent use of said easement, as shown on the survey.
First Amendment to Access Easement Agreement recorded April 17, 2007 as document R2007-069981.
Second Amendment to Access Easement Agreement recorded October 2, 2013 as document R2013-139513.
Acceptance of Common Area recorded November 6, 2009 as document R2009-168294. Item is blanket hereon.
- ㉒ Terms and provisions contained in Ordinance No. 2214 approving revised Plat of Subdivision, Revised Preliminary PUD Plan, Site Specific Amendments/Determinations for parking, setback and perimeter landscaping for Cantera Corporate Center recorded June 13, 2005 as document R2005-122472 and rerecorded October 28, 2005 as document R2005-241158. Item is blanket in nature.
- ㉓ Terms and provisions of restrictions and easement contained in Special Warranty Deed recorded October 2, 2002 as document R2002-256586, as shown on the survey. Item is platted hereon.
- ㉔ Terms and provisions contained in Stormwater Management Easement Agreement recorded April 17, 2007 as document R2007-069979 made by Duke Realty Limited Partnership, Duke Construction Limited Partnership and Joseph Morabito & Associates Illinois, LP, as shown on the survey. Item is platted hereon.
- ㉕ Terms and provisions contained in Plat of Easement Grant recorded April 9, 2007 as document R2007-064733 for 15' public utility easement with specific grants to Commonwealth Edison, SBC Illinois aka Illinois Bell Telephone Company and Nicor Gas Company, as shown on the survey. Item is platted hereon.
- ㉖ Terms and provisions contained in Plat of Easement Grant recorded April 17, 2007 as document R2007-069978 for public utilities to the City of Warrenville. Item is platted hereon.
- ㉗ Terms and provisions contained In Ordinance No. 2367 approving Preliminary/Final Plat of Subdivision and Minor PUD Amendments for Subarea F, Lot 2 and Final PUD for Lot F23 Office Development recorded April 17, 2007 as document R2007-069980. Item is blanket in nature.
- ㉘ Terms, provisions and easements as shown on the Plat of Cantera Crossings recorded May 30, 2007 as document R2007-099798, as shown on the survey, as follows:
a. 20' public utility easement running east to west through the middle of Lot 1; and
b. 20' public utility easement along the westerly line of Lot 1. Item is platted hereon.
- ㉙ Grant of Easement recorded September 12, 1994 as document R94-186788 made by Ronald Edward Stibbe and Roberia Jean Messer, as trustees, to the City of Warrenville for underground water line, and the terms, provisions and conditions contained therein, including Ordinance No. 1330 approving the execution by the City, as shown on the survey. (Affects the East 20 feet of part of Lot 2 Item is platted hereon.
- ㉚ Cantera SubArea F Resubdivision recorded April 23, 2002 as document R2002-110194 discloses the following, as shown on the survey:
a. 20' public utility easement along the Northerly line of Lot 2.
b. 100' building setback line from the center line of Bella Vista Parkway and 150' from the center line of Mill Street.
c. 60' parking setback line from the center line of Bella Vista Parkway and 135' from the center line of Mill Street and 10' along the Southerly and Westerly lot lines of Lot 1.
d. 80' building setback line from the South lot line of Lot 1.
e. 20' building setback line from the Westerly lot line of Lot 1.

ITEMS CORRESPONDING TO SCHEDULE B-II

- ㉛ Terms and provisions contained in the City of Warrenville Traffic Enforcement Agreement between Liberty/Warrenville LLC and the City of Warrenville dated September 23, 2013 and recorded October 2, 2013 as document R2013-139512. Item is not survey related.
- ㉜ Public Utility Easement and Irrigation Easement provisions contained in the Final Plat of Liberty Mutual at Cantera Resubdivision recorded October 2, 2013 as document R2013-139514. See Plat for exact locations.
Terms, conditions and provisions of Ordinance No. 2797 entitled An Ordinance Approving Revised Preliminary/Final Plat of Subdivision, Preliminary/Final Planned Unit Development and Site Specific Amendments/Determination for Lots 1 and 2 in Subarea F and Final Planned Unit Development for Lot 1 in Subarea F (Liberty Mutual Parking Lot Expansion) recorded October 2, 2013 as document R2013-139514. Item is platted hereon.
- ㉝ Permanent Nonexclusive Easement reserved for and granted to the City of Warrenville, Illinois Bell Telephone Company, Commonwealth Edison Company, and Nicor Gas Company and to all public utility and other companies of any kind operating under franchise granting them rights from the City of Warrenville, and to their successors and assigns for the purposes of servicing the property as disclosed in the Final Plat of Liberty Mutual at Cantera Resubdivision recorded October 2, 2013 as document R2013-139514. Item is blanket in nature.
- ㉞ Terms provisions, covenants, conditions and restrictions contained in the Declaration of Protective Covenants, Conditions and Resitricitions made by Liberty/Warrenville, LLC, dated August 28, 2014 and recorded September 24, 2014 as document R2014-087900. Item is not survey related.
- ㉟ Plat of Easement Grant and Plat of Abrogation over Lots 1 and 2 in Liberty Mutual Cantera Resubdivision, being a Resubdivision of Lots 1 and 2 of Cantera Crossings in the North Half of Section 1, Township 38 North, Range 9, East of the Third Principal Meridian, according to said Plat of Easement Grant and Plat of Abrogation recorded March 11, 2015 as document R2015-023922, along with the terms, conditions and easement provisions contained therein, as shown on the survey. See plat for exact locations. Item is platted hereon.
- ㊱ Easement in favor of Illinois Bell Telephone Company for pole lines, conduits and maintenance purposes granted by document R75-05265, and as disclosed by plats of subdivision, recorded on February 4, 1975, and the terms and conditions thereof, as shown on the survey. (Affects the Southerly 10 feet) Item is platted hereon.
- ㊲ Easement for underground utility as established by grant from Duke Realty Limited Partnership to Cantera Owners Association recorded as document R2002-256587, and the terms and conditions thereof, as shown on the survey. (affects the Southerly 10 feet) Item is platted hereon.

ZONING INFORMATION

THE SURVEYOR WAS PROVIDED WITH THE FOLLOWING ZONING INFORMATION. PZR ZONING REPORT #138540-3 DATED JUNE 16, 2020.

THE SUBJECT PROPERTY IS ZONED "S-D" - SPECIAL DEVELOPMENT DISTRICT OF THE CITY OF WARRENVILLE.

E-W TOLLWAY SETBACK: 80 FOOT BUILDING SETBACK WITH A 10 FOOT PARKING SETBACK
 MILL STREET SETBACK: 150 FOOT BUILDING SETBACK WITH AN 85 FOOT PARKING SETBACK
 NORTH LOT LINE SETBACK: 100 FOOT
 SOUTH-WEST LOT LINE SETBACK: 20 FOOT BUILDING SETBACK WITH A 10 FOOT PARKING SETBACK
 NORTH-WEST LOT LINE SETBACK: NONE SPECIFIED / NONE REQUIRED
 MAXIMUM BUILDING HEIGHT: 4 STORIES
 MINIMUM LOT AREA: NONE SPECIFIED
 MINIMUM LOT WIDTH: NONE SPECIFIED
 MINIMUM LOT DEPTH: NONE SPECIFIED
 MAXIMUM LOT COVERAGE: NONE SPECIFIED
 MAXIMUM FLOOR AREA RATIO: 0.35
 MINIMUM PARKING: FIRST 30,000 SQUARE FEET 4 PER 1,000 SQUARE FEET;
 NEXT SQUARE FEET 3.3 PER 1,000 SQUARE FEET. 510 SPACES REQUIRED.

| EXISTING PARKING SPACE TABLE | |
|------------------------------|----------------|
| TYPE OF SPACE | TOTAL EXISTING |
| REGULAR | 923 |
| ADA | 19 |
| MOTORCYCLE | 3 |
| TOTAL | 945 |

MISCELLANEOUS NOTES

- ① SURVEY PREPARED BY: JLH LAND SURVEYING INC. 910 GENEVA STREET SHOREWOOD, IL 60404 815.729.4000 INFO@JLHSURVEY.COM
- ② ALL FIELD MEASUREMENTS MATCH RECORD DIMENSIONS WITHIN THE PRECISION REQUIREMENTS OF ALTA/NSPS SPECIFICATIONS.
- ③ THIS PROFESSIONAL SERVICE CONFORMS TO THE CURRENT ILLINOIS MINIMUM STANDARDS FOR A BOUNDARY SURVEY.
- ④ ALL STREETS SHOWN ARE PUBLIC RIGHT OF WAY, UNLESS OTHERWISE NOTED.
- ⑤ ASSUMED BEARING: THE SOUTH RIGHT OF WAY LINE OF BELLA VISTA PARKWAY TO BE SOUTH 89 DEGREES 56 MINUTES 15 SECONDS EAST.
- ⑥ AT THE TIME OF THIS SURVEY THERE IS NO RECORD OR OBSERVED EVIDENCE OF A CEMETERY OR BURIAL GROUND.
- ⑦ AT THE TIME OF THIS SURVEY, THE ADDRESS WAS POSTED AS 27201 BELLA VISTA PARKWAY.
- ⑧ THE SUBJECT PROPERTY HAS DIRECT ACCESS TO AND FROM BELLA VISTA PARKWAY, A PUBLIC RIGHT OF WAY, WHICH IS GOVERNED BY THE CITY OF WARRENVILLE.
- ⑨ IN REGARDS TO TABLE "A" ITEM 16, AT THE TIME OF THIS SURVEY, THERE WAS NO VISIBLE EVIDENCE OF EARTH MOVING WORK, BUILDING CONSTRUCTION OR BUILDING ADDITIONS.
- ⑩ IN REGARDS TO TABLE "A" ITEM 17, AT THE TIME OF THIS SURVEY, THERE WAS NO RECENT STREET OR SIDEWALK CONSTRUCTION OR PROPOSED RIGHT OF WAY CHANGES PROVIDED.
- ⑪ IN REGARDS TO TABLE "A" ITEM 18, AT THE TIME OF THE SURVEY, THERE WAS NO STAKED WETLAND DELINEATION TO REFERENCE ON THIS SURVEY.
- ⑫ THE LOTS ARE CONTIGUOUS AND WE FIND NO GAPS OR OVERLAPS ON THE PROPERTY.

LEGAL

THE USE OF THIS DOCUMENT'S FORMAT IS STRICTLY PROHIBITED AND CONTINGENT UPON THE WRITTEN CONSENT AND PERMISSION OF BOCK & CLARK CORPORATION, AN NV5 COMPANY. © 2020 BOCK AND CLARK CORPORATION, AN NV5 COMPANY.

THIS SURVEY WAS PREPARED FOR THE PURPOSE OF THIS REAL ESTATE TRANSACTION ONLY AND NO FURTHER PARTIES OTHER THAN THOSE CERTIFIED ABOVE SHALL RELY ON IT FOR ANY OTHER PURPOSE OR TRANSACTION.

RECORD DESCRIPTION

- Parcel 1:
 Lots 1 and 2 in Final Plat of Liberty Mutual at Cantera Resubdivision, being a Resubdivision of Lots 1 and 2 in Cantera Crossing, in the North Half of Section 1, Township 38 North, Range 9, East of the Third Principal Meridian, according to the Plat of said Final Plat of Liberty Mutual at Cantera Resubdivision recorded October 2, 2013 as document R2013-139514, in DuPage County, Illinois.
- Parcel 2:
 Non-exclusive easement for the benefit of Parcel 1 for vehicular and pedestrian ingress and egress to Bella Vista Parkway over the "Easement Area" as set forth and defined in Access Easement Agreement recorded June 13, 2005 as document R2005-122469, as modified by First Amendment to Access Easement Agreement recorded April 17, 2007 as document R2007069981.
- Parcel 3:
 Non-exclusive easement for the benefit of Parcel 1 to drain stormwater into the "Stormwater Management Easement Area" set forth and defined in Plat of Cantera SubArea F recorded August 5, 1999 as document R1999-171251.
- Parcel 4:
 Non-exclusive easement for the benefit of Parcel 1 for stormwater maintenance over "Stormwater Management Easement No. 1" set forth and defined in Plat of Easement Grant attached as Exhibit D to Stormwater Management Easement Agreement recorded April 17, 2007 as document R2007-069979.
- Parcel 5:
 Non-exclusive easement for the benefit of Parcel 1, Lot 1, as granted in Cantera Corporate Center Final Subdivision Plat of Lot 2 Subarea F - Warrenville, Illinois recorded June 13, 2005 as Document R2005-122468, as shown thereon.

THE LANDS SURVEYED, SHOWN AND DESCRIBED HEREON ARE THE SAME LANDS AS DESCRIBED IN THE TITLE COMMITMENT PROVIDED BY COMMONWEALTH LAND TITLE INSURANCE COMPANY, COMMITMENT NO. FCH12000295LI, DATED MAY 1, 2020.

ALTA/NSPS LAND TITLE SURVEY

for
TLM FIVE
 NV5 PROJECT NO. 202001858-001
 27201 & 27501 BELLA VISTA PARKWAY, WARRENVILLE, IL


BASED UPON TITLE COMMITMENT NO. FCH12000295LI
 OF COMMONWEALTH LAND TITLE INSURANCE COMPANY
 BEARING AN EFFECTIVE DATE OF MAY 1, 2020

SURVEYOR'S CERTIFICATION

TO: 27201 BELLA VISTA PKY WARRENVILLE ILLINOIS, LLC, A DELAWARE LIMITED LIABILITY COMPANY; 27201 BELLA VISTA PKY WARRENVILLE, LLC, A DELAWARE LIMITED LIABILITY COMPANY; 27201 BELLA VISTA PKY WARRENVILLE LAND, LLC, A DELAWARE LIMITED LIABILITY COMPANY; TWENTY LAKE MANAGEMENT, LLC, A DELAWARE LIMITED LIABILITY COMPANY; COMMONWEALTH LAND TITLE INSURANCE COMPANY AND BOCK & CLARK CORPORATION, AN NV5 COMPANY.


THIS IS TO CERTIFY THAT THIS MAP OR PLAT AND THE SURVEY ON WHICH IT IS BASED WERE MADE IN ACCORDANCE WITH THE 2016 MINIMUM STANDARD DETAIL REQUIREMENTS FOR ALTA/NSPS LAND TITLE SURVEYS, JOINTLY ESTABLISHED AND ADOPTED BY ALTA AND NSPS, AND INCLUDES ITEMS 1, 2, 3, 4, 6a, 6b, 7a, 7b1, 7c, 8, 9, 13, 14, 16, 17, 18 AND 20 OF TABLE A THEREOF. THE FIELD WORK WAS COMPLETED ON MAY 21, 2020.

JAMES L. HARPOLE
 REGISTRAR NO. 035-3190
 IN THE STATE OF ILLINOIS, EXPIRES 11-30-2020
 ILLINOIS PROFESSIONAL DESIGN FIRM NO. 184.007120
 NETWORK PROJECT NO. 202001858-001 RRF

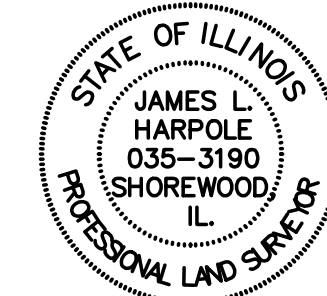

SHEET 1 OF 2

Bock & Clark Corporation
 an NV5 Company

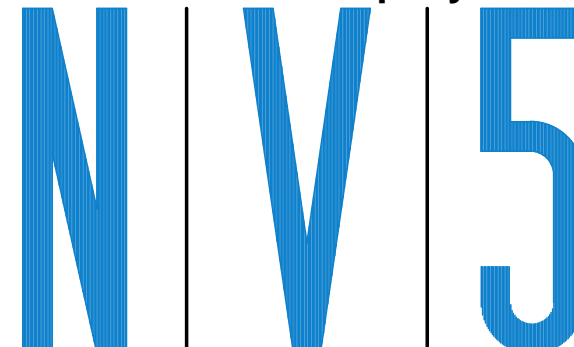

Transaction Services 1-800-SURVEYS (787-8397)
 3550 W. Market Street, Suite 200, Akron, Ohio 44333
 www.BockandClark.com maywehelpyou@bockandclark.com www.NV5.com

SURVEY • ZONING • ENVIRONMENTAL • ASSESSMENT


FLOOD NOTE:
 BY GRAPHIC PLOTTING ONLY, THIS PROPERTY IS IN ZONE(S) _____ OF THE FLOOD INSURANCE RATE MAP, COMMUNITY PANEL NO. 1704300141A WHICH BEARS AN EFFECTIVE DATE OF 09/01/2019 AND IS NOT IN A SPECIAL FLOOD HAZARD AREA, BY CONTACT DATED 06/04/2020 TO THE NATIONAL FLOOD INSURANCE PROGRAM http://www.fema.gov/ WE HAVE LEARNED THIS COMMUNITY DOES CURRENTLY PARTICIPATE IN THE PROGRAM. NO FIELD SURVEYING WAS PERFORMED TO DETERMINE THIS ZONE AND AN ELEVATION CERTIFICATE MAY BE NEEDED TO VERIFY THIS DETERMINATION OR APPLY FOR A VARIANCE FROM THE FEDERAL EMERGENCY MANAGEMENT AGENCY.

SIGNIFICANT OBSERVATIONS

NONE WERE OBSERVED.


PROJECT REVISION RECORD

| DATE | DESCRIPTION | DATE | DESCRIPTION |
|---------------------|-----------------|-----------------|------------------------|
| 06/04/2020 | FIRST DRAFT | 06/18/2020 | ZONING & REVISED TITLE |
| 06/05/2020 | NETWORK REVIEW | 06/24/2020 | REVISED ZONING & TITLE |
| 06/11/2020 | REVISE LOT AREA | 07/17/2020 | CLIENT COMMENTS |
| FIELD WORK: DB & RC | | DRAFTED: JAH | |
| | | CHECKED BY: JLH | |
| | | FB & PG: NA | |

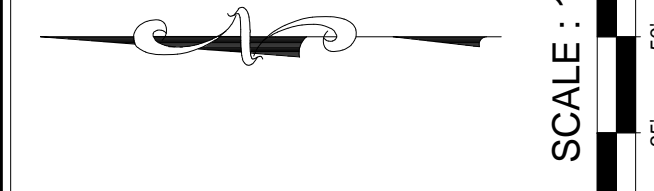

LEGEND OF SYMBOLS & ABBREVIATIONS

| | | |
|-------------------|----------------------------|--------------------------------|
| ○ UTILITY POLE | ○ MANHOLE | ○ P.O.C. POINT OF COMMENCEMENT |
| ○ LIGHT POLE | ○ SANITARY MANHOLE | ○ P.O.B. POINT OF BEGINNING |
| ○ TRANSFORMER | ○ STORM STRUCTURE (CLOSED) | ○ FEENCES |
| ○ UTILITY/RESTAL | ○ STORM STRUCTURE (OPEN) | ○ FEET MARKERS |
| ○ TRAFFIC SIGNAL | ○ CURB WALK | ○ INCHES/FEET |
| ○ SIGNAL BOX | ○ VALVE VAULT | S.F. SQUARE FEET |
| ○ GAS VALVE | ○ FURD END SECTION | (R) RECORD BEARING/DISTANCE |
| ○ WATER VALVE | ○ TELEPHONE/COAX LINE | (F) FINISHED FLOOR |
| ○ ELECTRIC METER | ○ GAS LINE | (T) TOP OF PIPE |
| ○ FIRE HYDRANT | ○ ELECTRIC LINE | B.S.L. BUILDING SETBACK LINE |
| ○ AUTO SPRINKLER | ○ OVERHEAD WIRES | P.U.L. PUBLIC UTILITY EASEMENT |
| ○ MONITORING WELL | ○ STIM-STORM SEWER | D.C. DRAINAGE EASEMENT |
| ○ GROUND LIGHT | ○ SAN-SANITARY SEWER | L ARC LENGTH |
| ○ BOLLARD | ○ CHAIN LINK FENCE | R RADIUS LENGTH |
| ○ B/BOX | ○ STORAGE FENCE | C CHORD LENGTH |
| ○ SIGN | ○ GARD RAIL | CB CHORD BEARING |
| ○ FLAG POLE | ○ CORRUGATED METAL PIPE | |

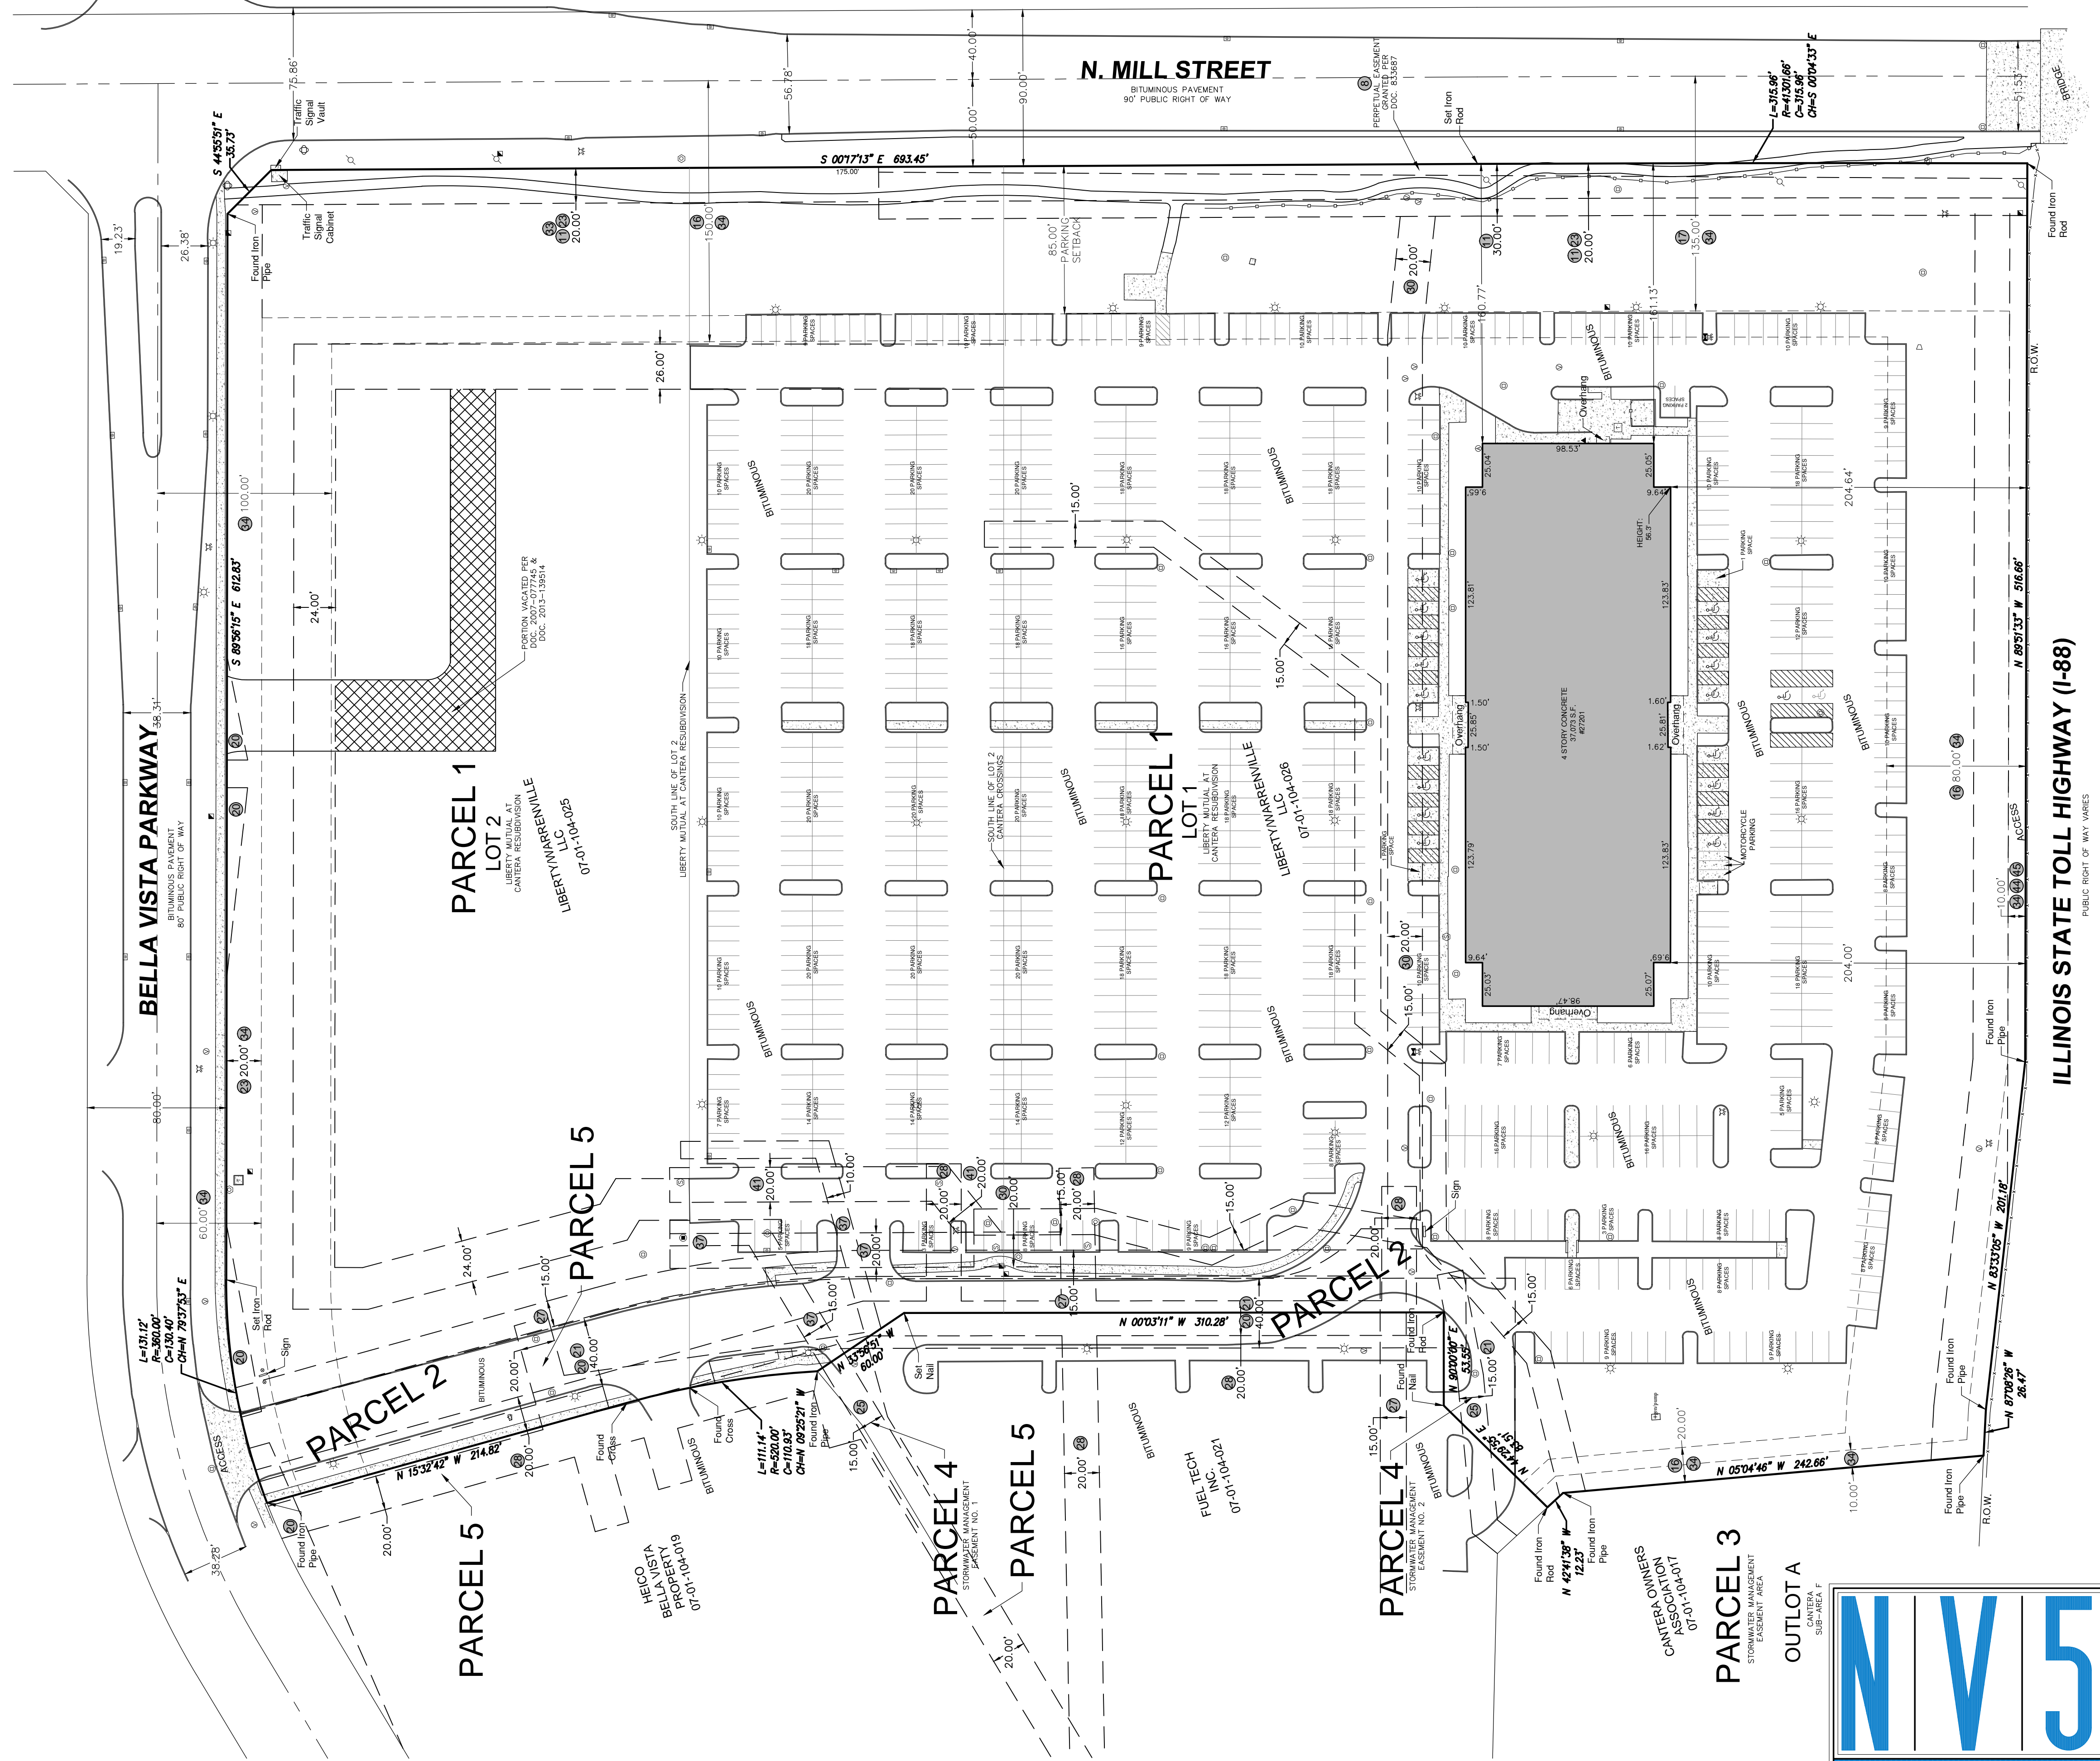

ILLINOIS STATE TOLL HIGHWAY (I-88)
PUBLIC RIGHT OF WAY VARIES

NV5

ALTA/NSPS LAND TITLE SURVEY
PREPARED FOR
TLM FIVE
DATE OF FIELD SURVEY: MAY 21, 2020
NETWORK PROJECT NUMBER: 202001858-001 RRF
1-(800)-SURVEYS (787-8397)
TRANSACTION SERVICES
www.bockandclark.com maywehelpyou@bockandclark.com www.NV5.com

SURVEY • ZONING • ENVIRONMENTAL • ASSESSMENT